

# MARION COUNTY SURVEYOR'S OFFICE



## SECTION CORNER RECORD

DEBRA S. JENKINS  
MARION COUNTY SURVEYOR

SEC. 13 TWN. 16<sub>N</sub> RNG. 2<sub>E</sub>

BRYAN F. CATLIN, PLS  
TECHNICAL SUPERVISOR

Date: 5-29-09  
Party Chief: Wilcoxon  
Crew: Finney  
Type of Marker: Harrison  
Method of Establishment: County: 10-3-1994  
IN S.P.C. E Zone, NAD 83  
Name: 16021302  
N: 509 738.743 0(m)  
E: 49 115.346 0(m)

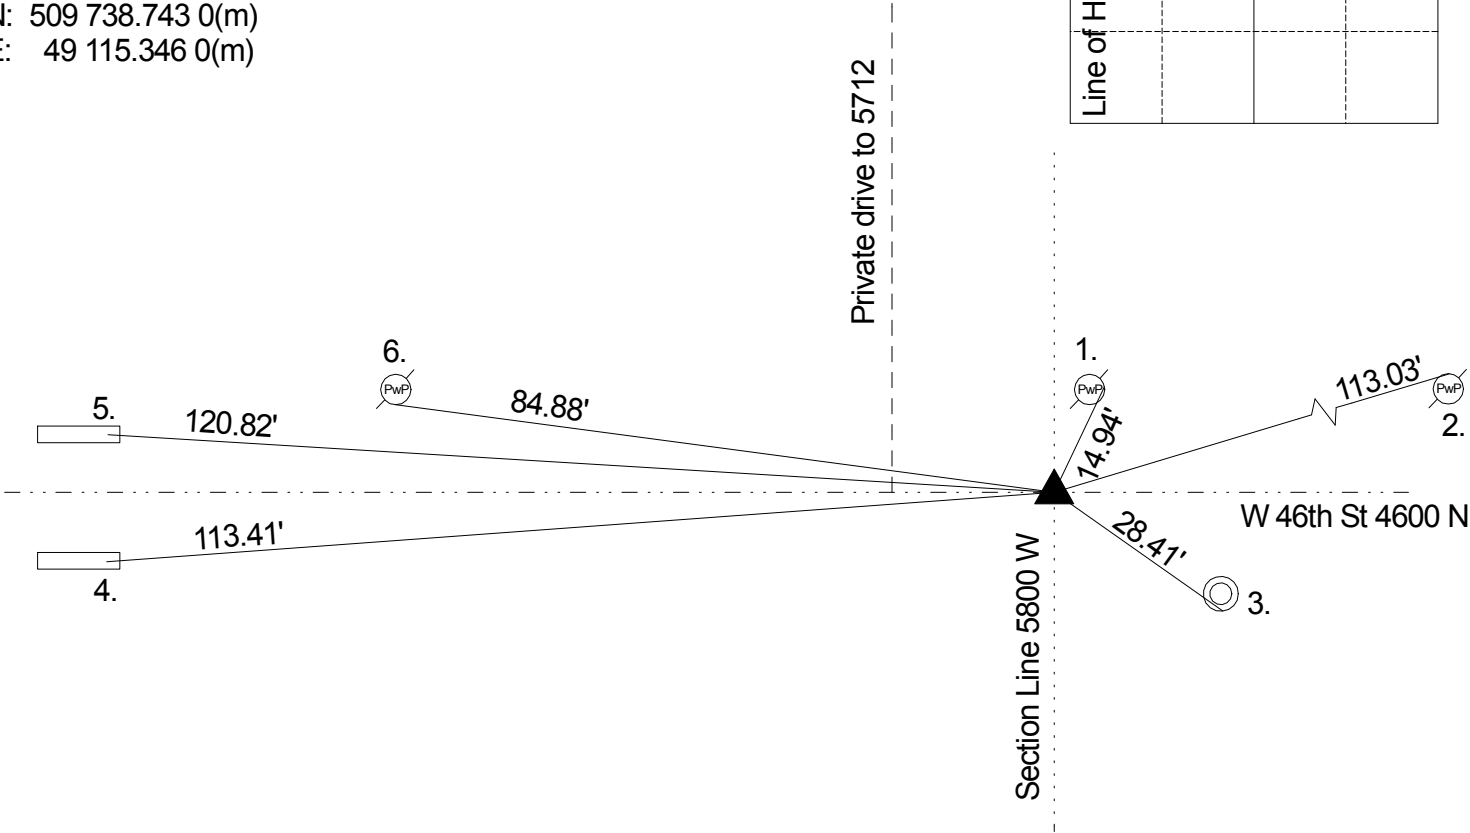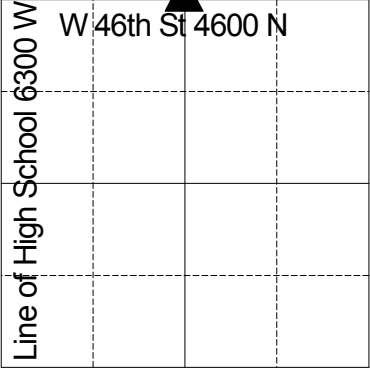

Corner originally set as a post in 1820 by Wm. B. Laughlin with the following witnesses: 14” beech bearing S 66 E 14 links and an 18” dogwood bearing N 77 W 4 links. ( Marion County Atlas p. 3) A survey by H.B. Fatout on January 16, 1878 indicates no stone or witnesses.( Pike Legal Book p. 6) Corner referenced by MCS at an unknown date on old tie card and called an unknown monument. Corner referenced by Wilcoxon on 4/7/1976 and called a RR spike. Corner referenced by Greene on 9/13/85 and called a RR spike. Corner referenced by Kiste on 10/3/94 and called a RR spike 3” down. Corner referenced by Kiste on 6/8/1999 and called a RR spike 3” down. Corner referenced by Kiste on 9/20/2005 and called a RR spike 3” down. Corner excavated by Wilcoxon on 5/27/09 and a RR spike was found inside a wooden post 4” down. A stone with a guard pin was found 15” down. A #205 cast iron Harrison monument was set on top of stone.

REF.	DISTANCE	DESCRIPTION
1.	14.94'	PK nail E PwP #23-354 A 12" up
2.	113.03'	PK nail N PwP #1-355 A 8" up
3.	28.41'	Cut 'x' S rim Bell manhole
4.	113.41'	Cut 'x' E end of concrete headwall
5.	120.82'	Cut 'x' E end of concrete headwall
6.	84.88'	PK nail S PwP #24-354 A 24" up